
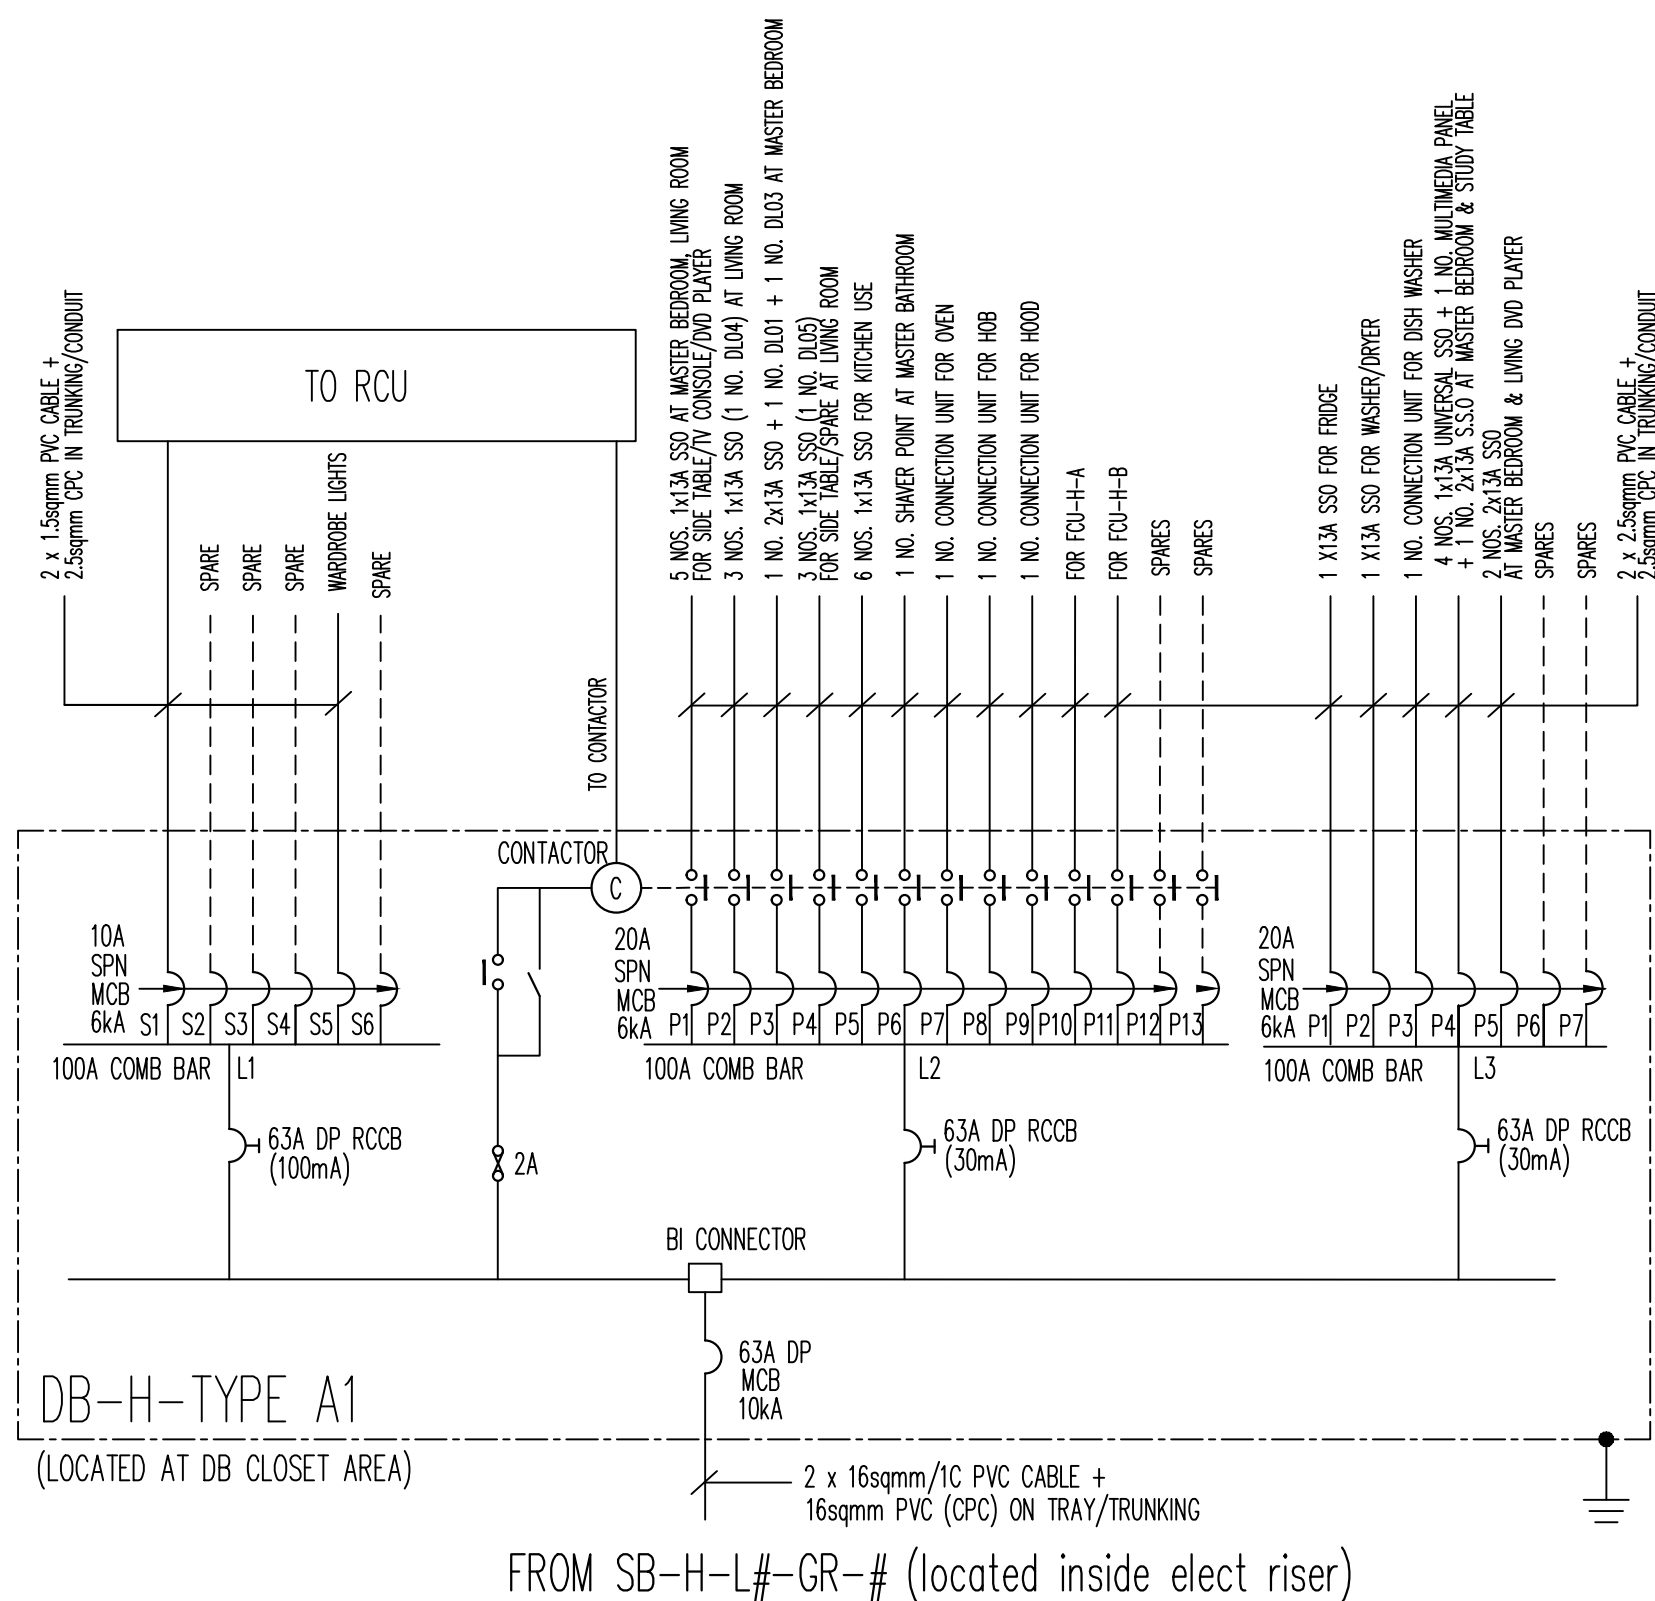


WELCOME SCENCE : ON
LS-1 = 6
LS-3 = 13
LS-5 = 8
LS-6 = 14


MASTER : OFF
LS-7 = 5
LS-8 = 7
LS-9 = 10
LS-10 = 11
LS-12 = 15
LS-13 = 7
LS-14 = 4
LS-15 = 3

TYPICAL FLOOR

# 5-5	# 13-5
# 6-5	# 14-5
# 7-5	# 15-5
# 8-5	# 16-5
# 9-5	# 17-5
# 10-5	# 18-5
# 11-5	# 19-5
# 12-5	# 20-5

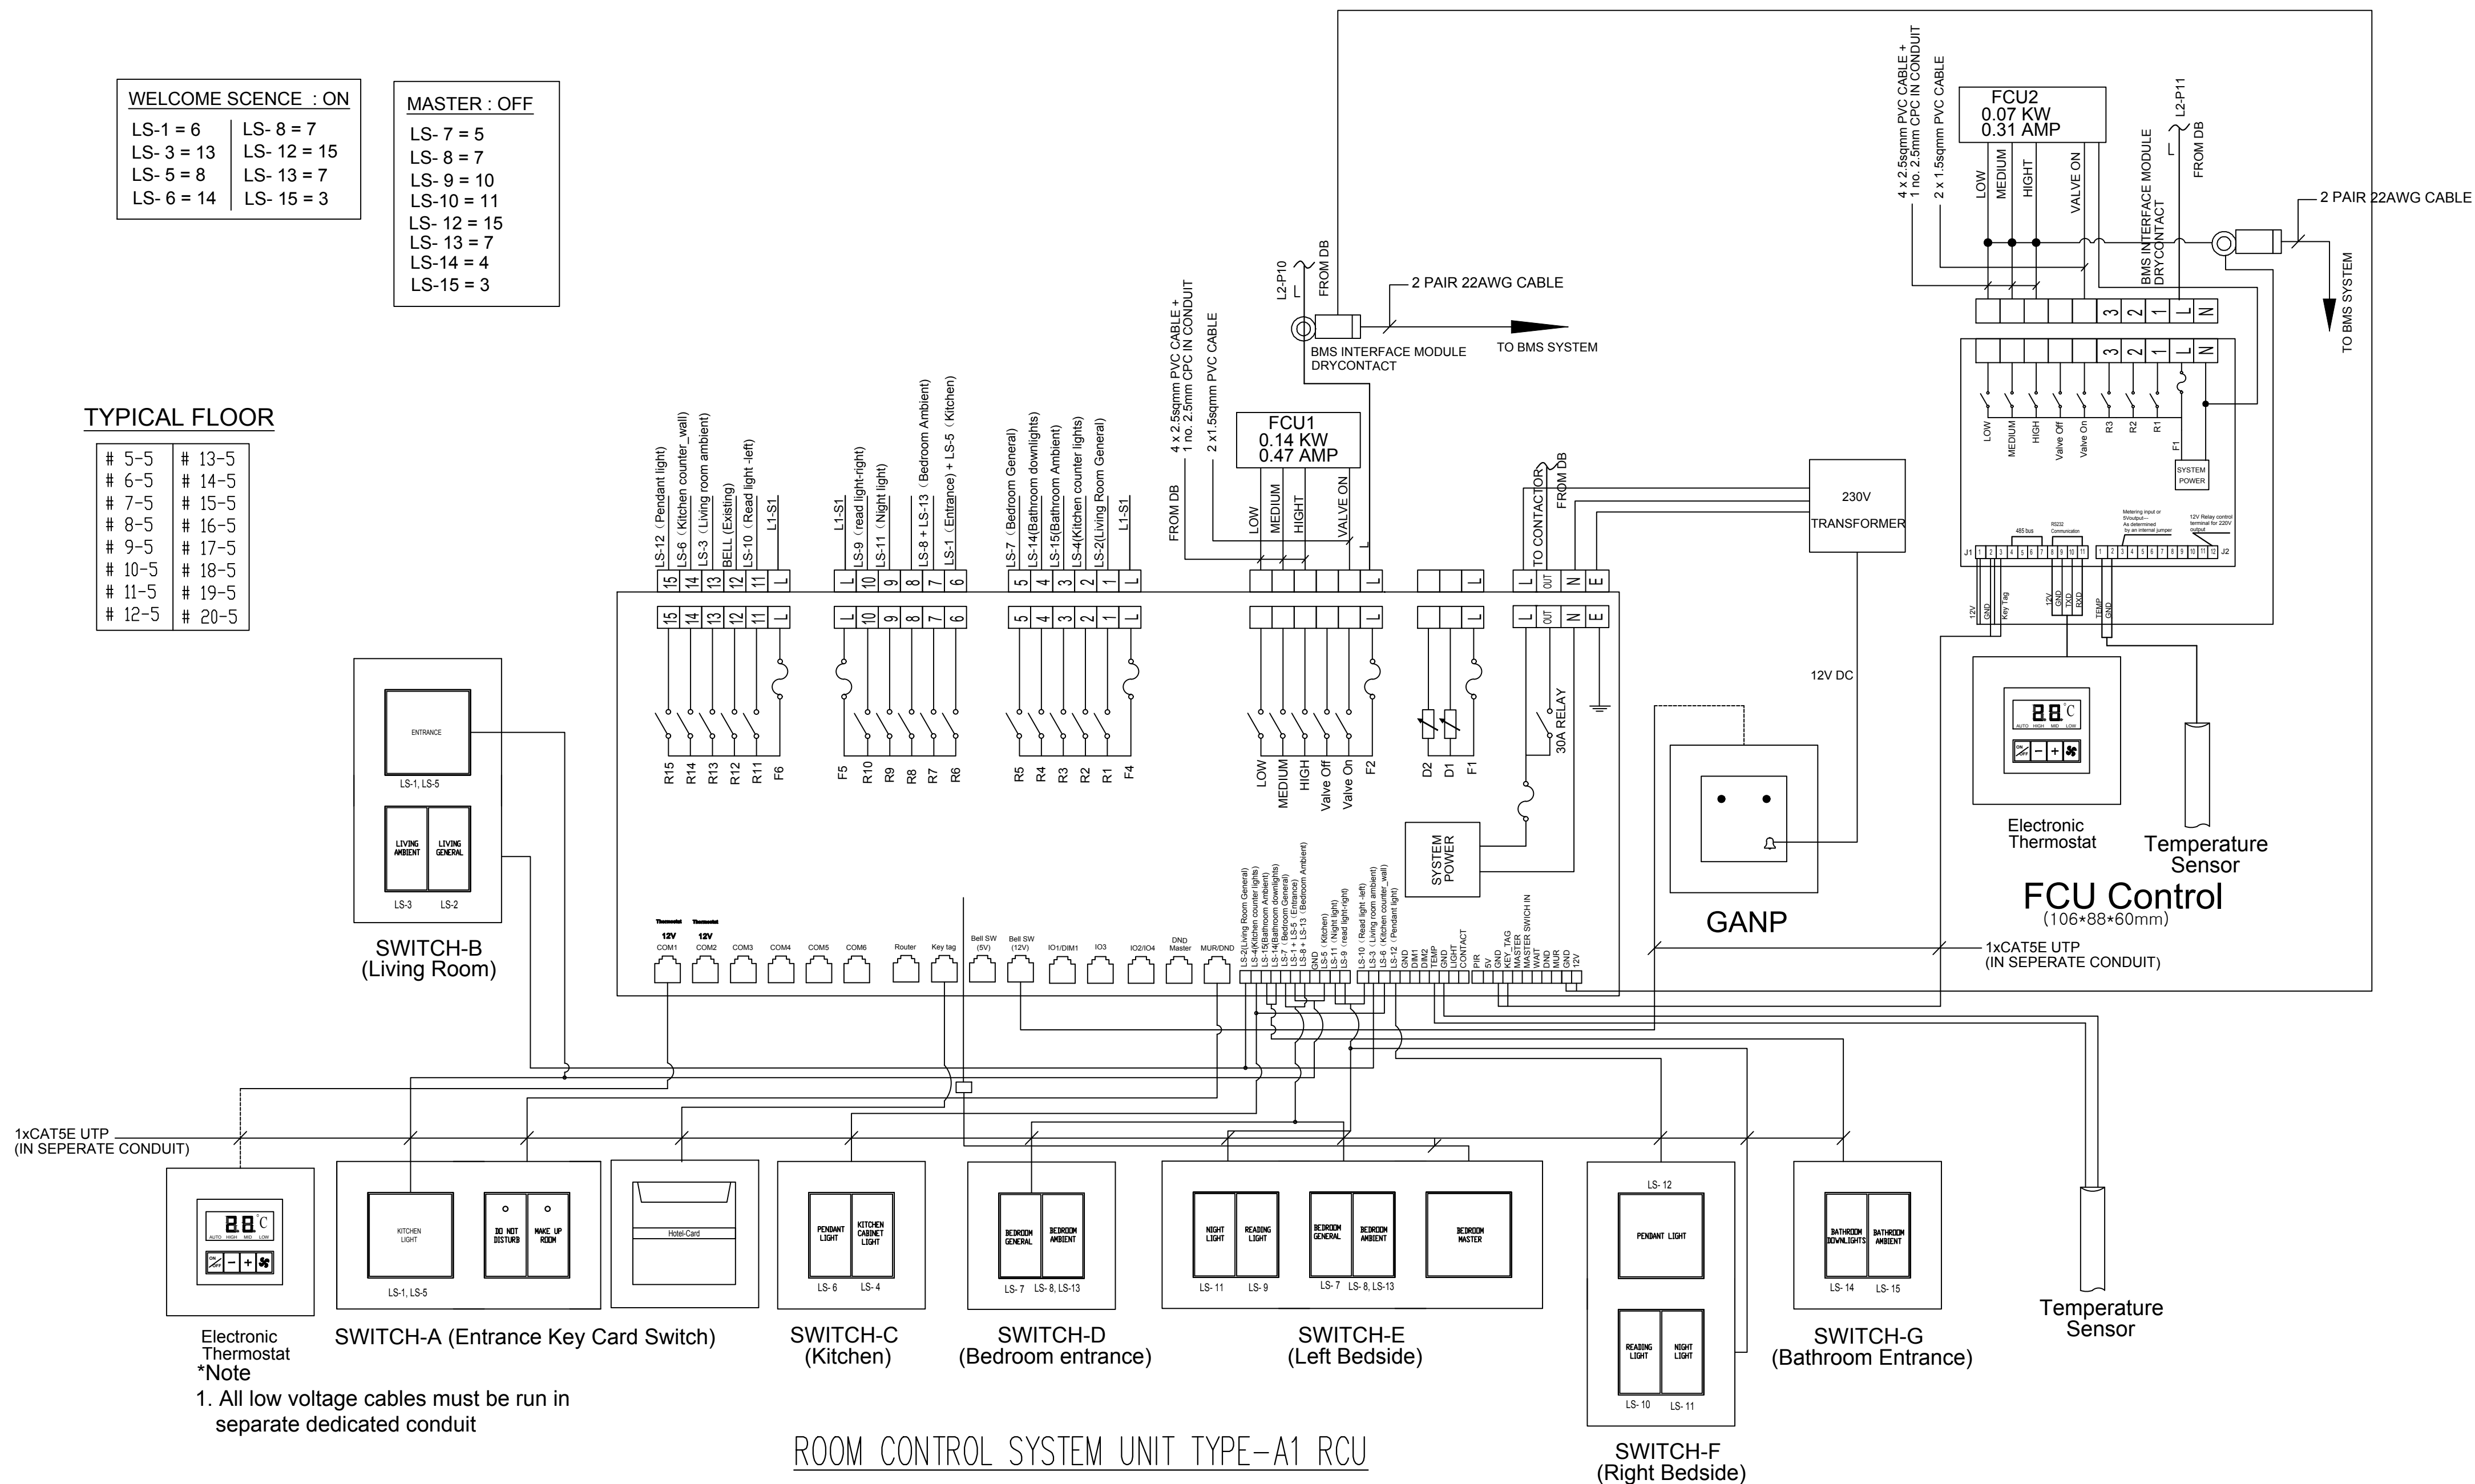

KEY PLAN

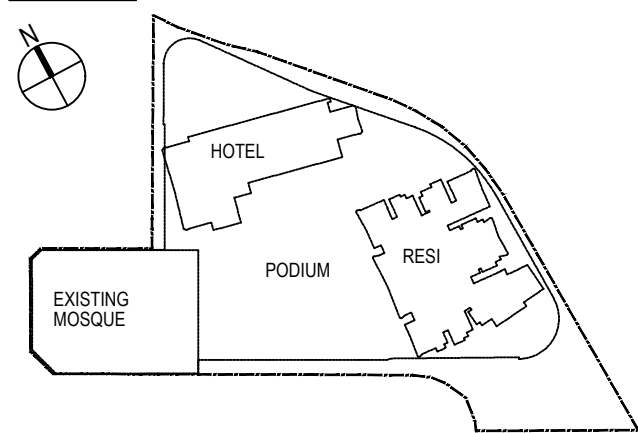

WE, WOH HUP (PRIVATE) LIMITED, HEREBY CERTIFY THAT THIS AS-BUILT DRAWING REFLECTS THE ACTUAL INSTALLATION ON SITE AND WE ARE FULLY RESPONSIBLE FOR THE ACCURACY AND CORRECTNESS OF THIS AS-BUILT DRAWING.

SIGNATURE :
COMPANY STAMP :
DATE :

AS-BUILT DRAWING

PROJECT TITLE

PROPOSED MIXED DEVELOPMENT COMPRISING 1 BLOCK OF 30-STOREY RESIDENTIAL APARTMENT (268 UNITS) WITH ANCILLARY FACILITIES, 1 BLOCK OF 20-STOREY HOTEL (220 ROOMS) WITH ANCILLARY FACILITIES AND 6-STOREY PODIUM CARPARK (INCLUDING A PUBLIC CARPARK STATION) WITH 7TH STOREY LANDSCAPE DECK INCORPORATING A&A TO EXISTING MOSQUE ON LOTS 00918K, 01381K (P&A 00917A-P1) TS 27 AT CAIRNHILL ROAD/ BIDEFORD ROAD (ORCHARD PLANNING AREA)

Owner
CH RESIDENTIAL PTE. LTD. /
CH COMMERCIAL PTE. LTD.

168 Robinson Road #30-01 Capital Tower Singapore 068912
Tel: 6820-2188 Fax: 6820-8679

Architect
RSP
RSP ARCHITECTS PLANNERS & ENGINEERS (PTE.) LTD.

15 Scotts Road #07-00 Thong Tek Building Singapore 228218
Tel: 6737-7544 Fax: 6733-9143

Structural Consultant

AECOM
AECOM SINGAPORE PTE. LTD.

300 Beach Road #03-00 The Concourse Singapore 199555
Tel: 6-299-2486 Fax: 6-299-0297

M&E Consultant

Beca
Beca Carter Hollings & Ferner (S.E. Asia) Pte. Ltd.

1 Gateway Drive, #12-01 Westgate Tower Westgate Mall, 608531
Tel: 6220-7588 Fax: 6225-6937

Landscape Consultant

COEN Design International Pte. Ltd.

4 Ean Kiam Place Singapore 429105
Tel: 6327-4452 Fax: 6327-8042

Main Contractor

Woh Hup (Private) Limited

217 Upper Bukit Timah Road Singapore 588185
Tel: 6385-8585 Fax: 6272-3322

Sub Contractor

POWEN ENGINEERING PTE LTD
54 HILLVIEW TERRACE SINGAPORE 669272
T : (65) 6488 8888 F : (65) 6763 1908
www.powen.com.sg

Scale : N.T.S Date : 12.04.16

Drawing Title:
ELECTRICAL INSTALLATION
TYPICAL UNIT TYPE A1(HOTEL UNIT)
SINGLE LINE DIAGRAM

Drawn By : MTK Checked By : LYC

Drawing No. WH/CHR/M&E/EL/HU-502 Size A1
(ASCOTT ORCHARD SINGAPORE)